256R

WELL LOCATION PLAN
FOR
EARTH TECH, INC.
IN
SEABROOK, NH

SCALE: 1"=100' MAY 1998 REVISED JUNE 1998

PREPARED BY
STOCKTON SERVICES
PO BOX 1306 HAMPTON, NH 03843
(603) 474-1954

THE PURPOSE OF THIS PLAN IS TO VERIFY THE LOCATION OF WELL 1-97 AND 1A WITH RESPECT TO EXISTING BOUNDARIES AS PREVIOUSLY DETERMINED AND SURVEYED BY PARKER SURVEY ASSOC. BOUNDARY INFORMATION FOR NEW HAMPSHIRE PORTION OF RILEY WELL FIELD IS REPRODUCED FROM:

PLAN OF RILEY WELL FIELD FOR TOWN OF SEABROOK IN SEABROOK, NH AND SALISBURY, MA, SCALE: 1"=100', JAN 1981, PARKER SURVEY ASSOC., INC., EXETER & SEABROOK, NH. (PLAN #4178)

REVISED JUNE 18, 1998 TO ADD WETLAND BOUNDARIES AS FLAGGED BY EARTH TECH ON JUNE 4. FIELD LOCATIONS PERFORMED ON JUNE 10 AND JUNE 17, 1998.

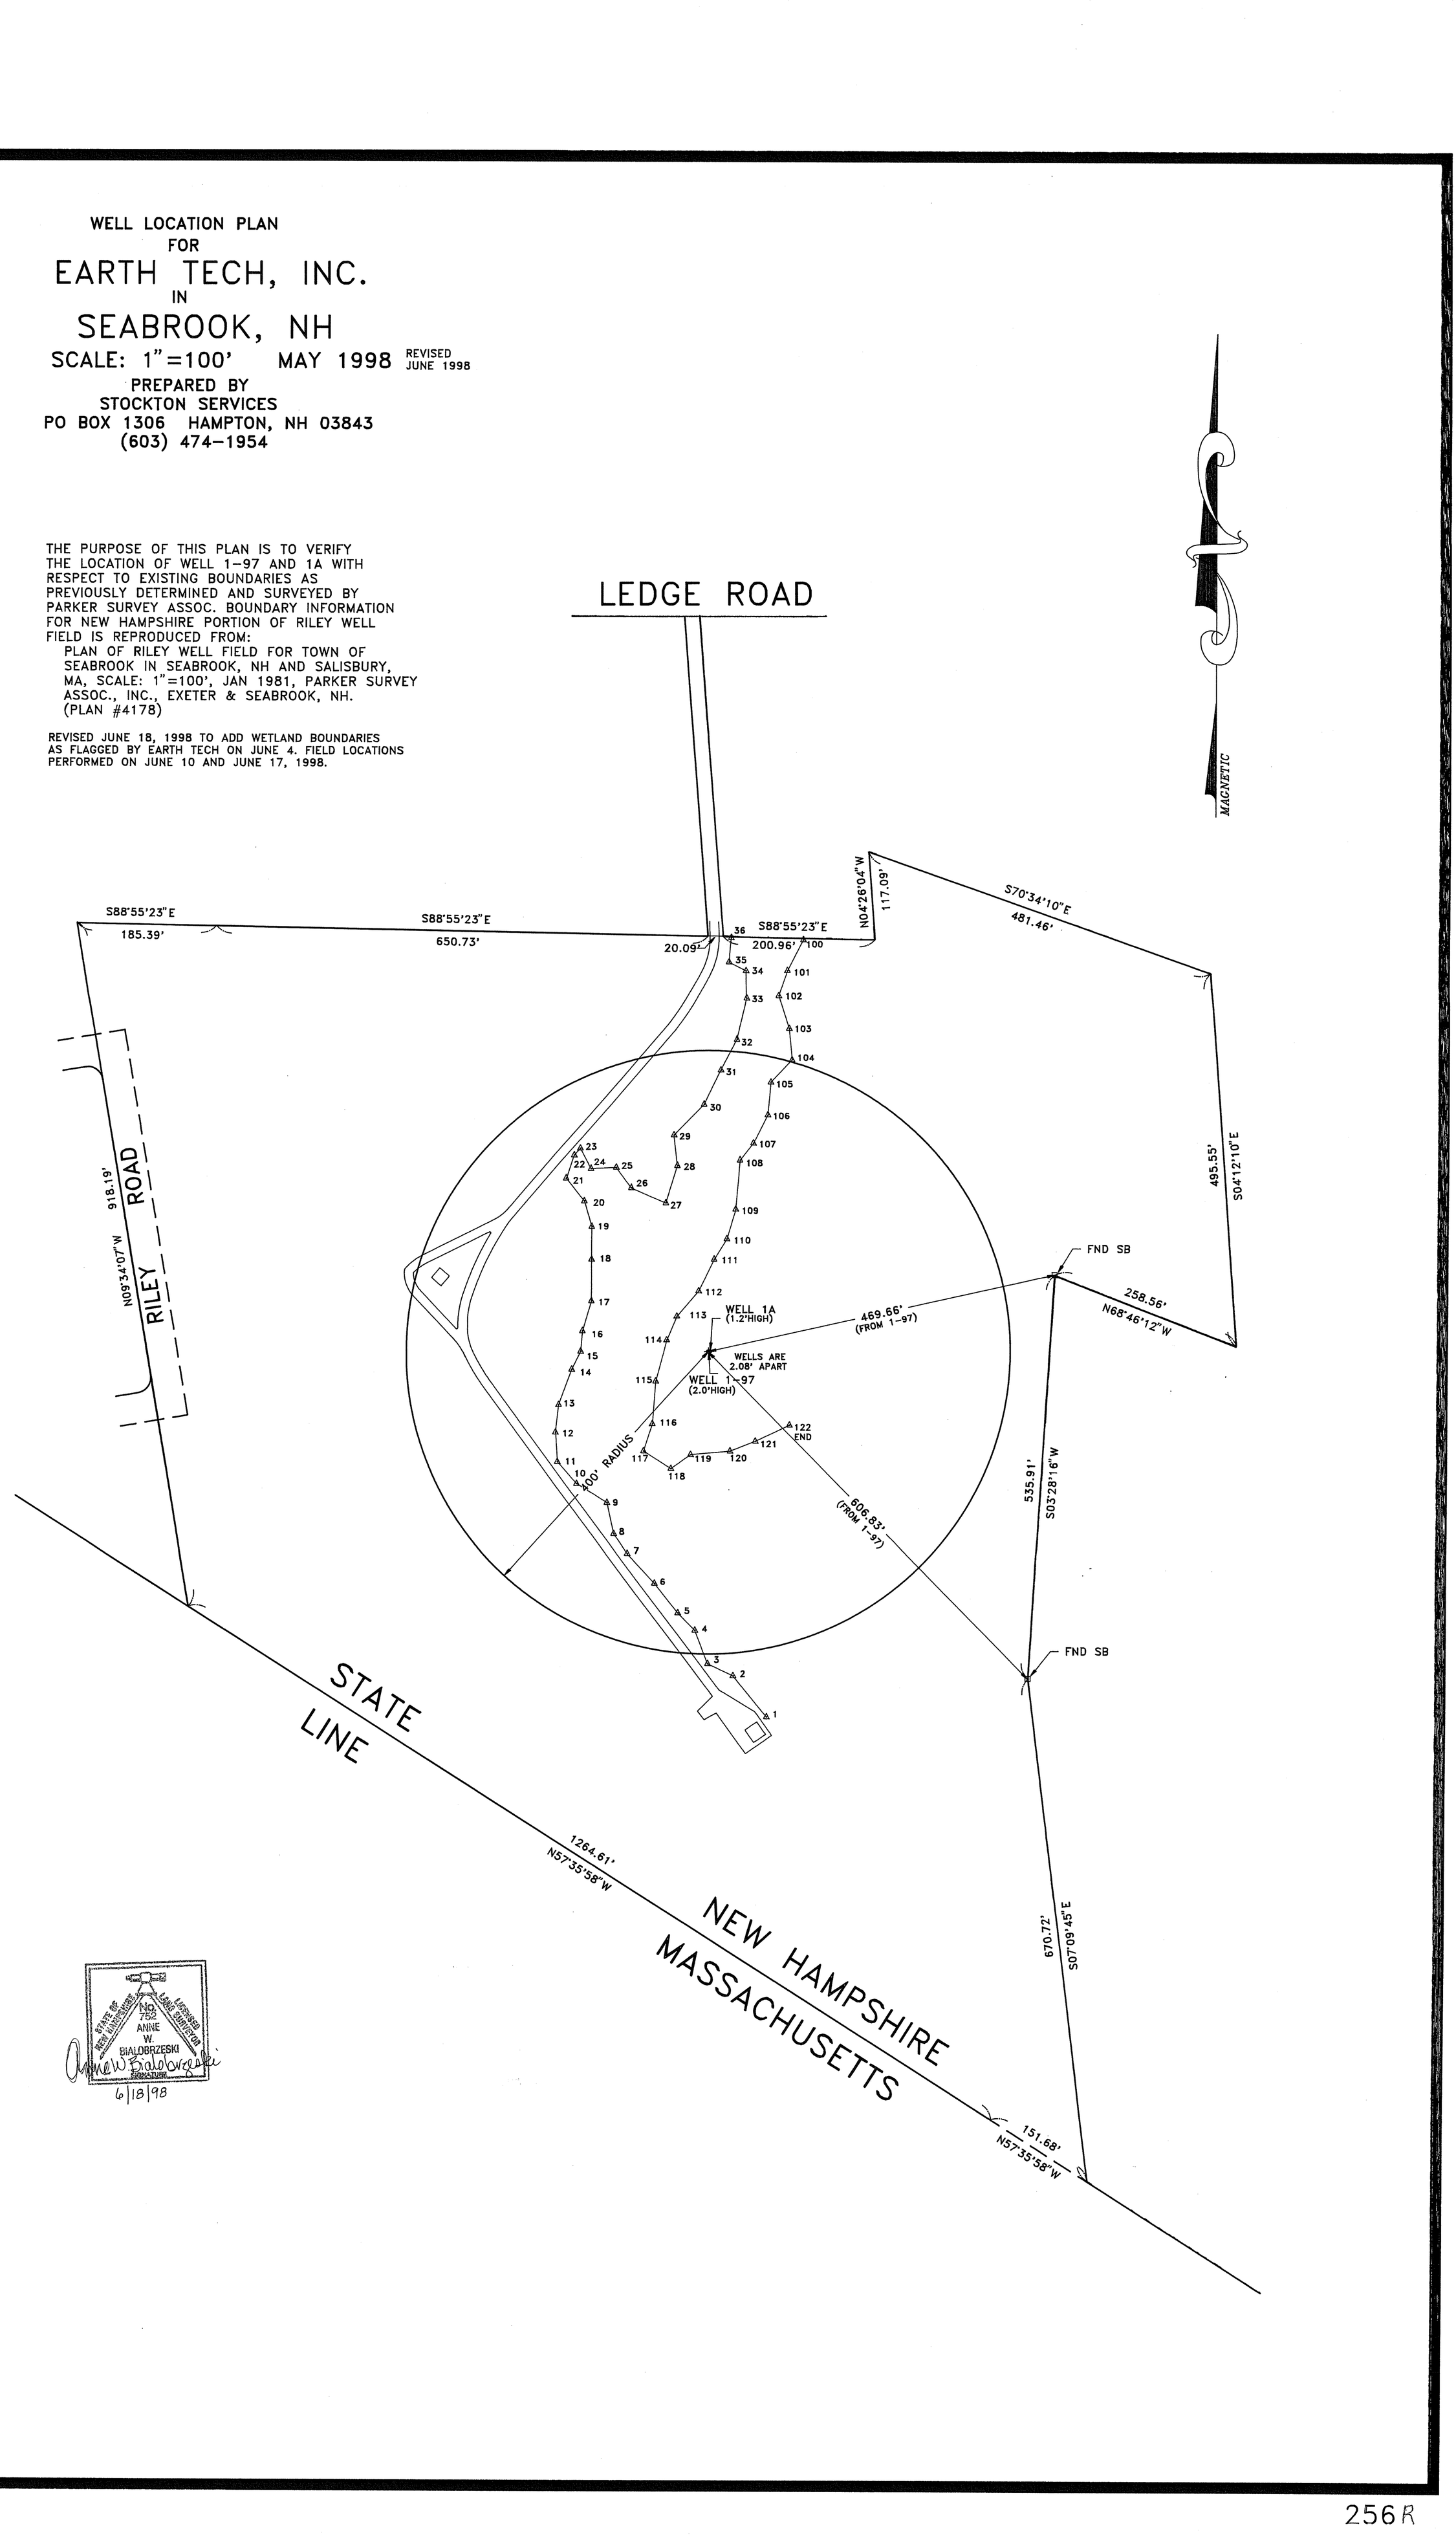

STATE OF NEW HAMPSHIRE LICENSED LAND SURVEYOR
No. 752
ANNE W. BIALOBRZESKI
SIGNATURE
Anne W. Bialobrzeski
6/18/98

256R

256 R3

WELL LOCATION PLAN
FOR
EARTH TECH, INC.
IN
SEABROOK, NH

SCALE: 1"=100' MAY 1998

REVISED
JUNE 1998
SEPT 1998
DEC 1998

PREPARED BY
STOCKTON SERVICES
PO BOX 1306 HAMPTON, NH 03843
(603) 474-1954

THE PURPOSE OF THIS PLAN IS TO VERIFY THE LOCATION OF WELL 1-97 AND 1A WITH RESPECT TO EXISTING BOUNDARIES AS PREVIOUSLY DETERMINED AND SURVEYED BY PARKER SURVEY ASSOC. BOUNDARY INFORMATION FOR NEW HAMPSHIRE PORTION OF RILEY WELL FIELD IS REPRODUCED FROM:
PLAN OF RILEY WELL FIELD FOR TOWN OF SEABROOK IN SEABROOK, NH AND SALISBURY, MA, SCALE: 1"=100', JAN 1981, PARKER SURVEY ASSOC., INC., EXETER & SEABROOK, NH. (PLAN #4178)

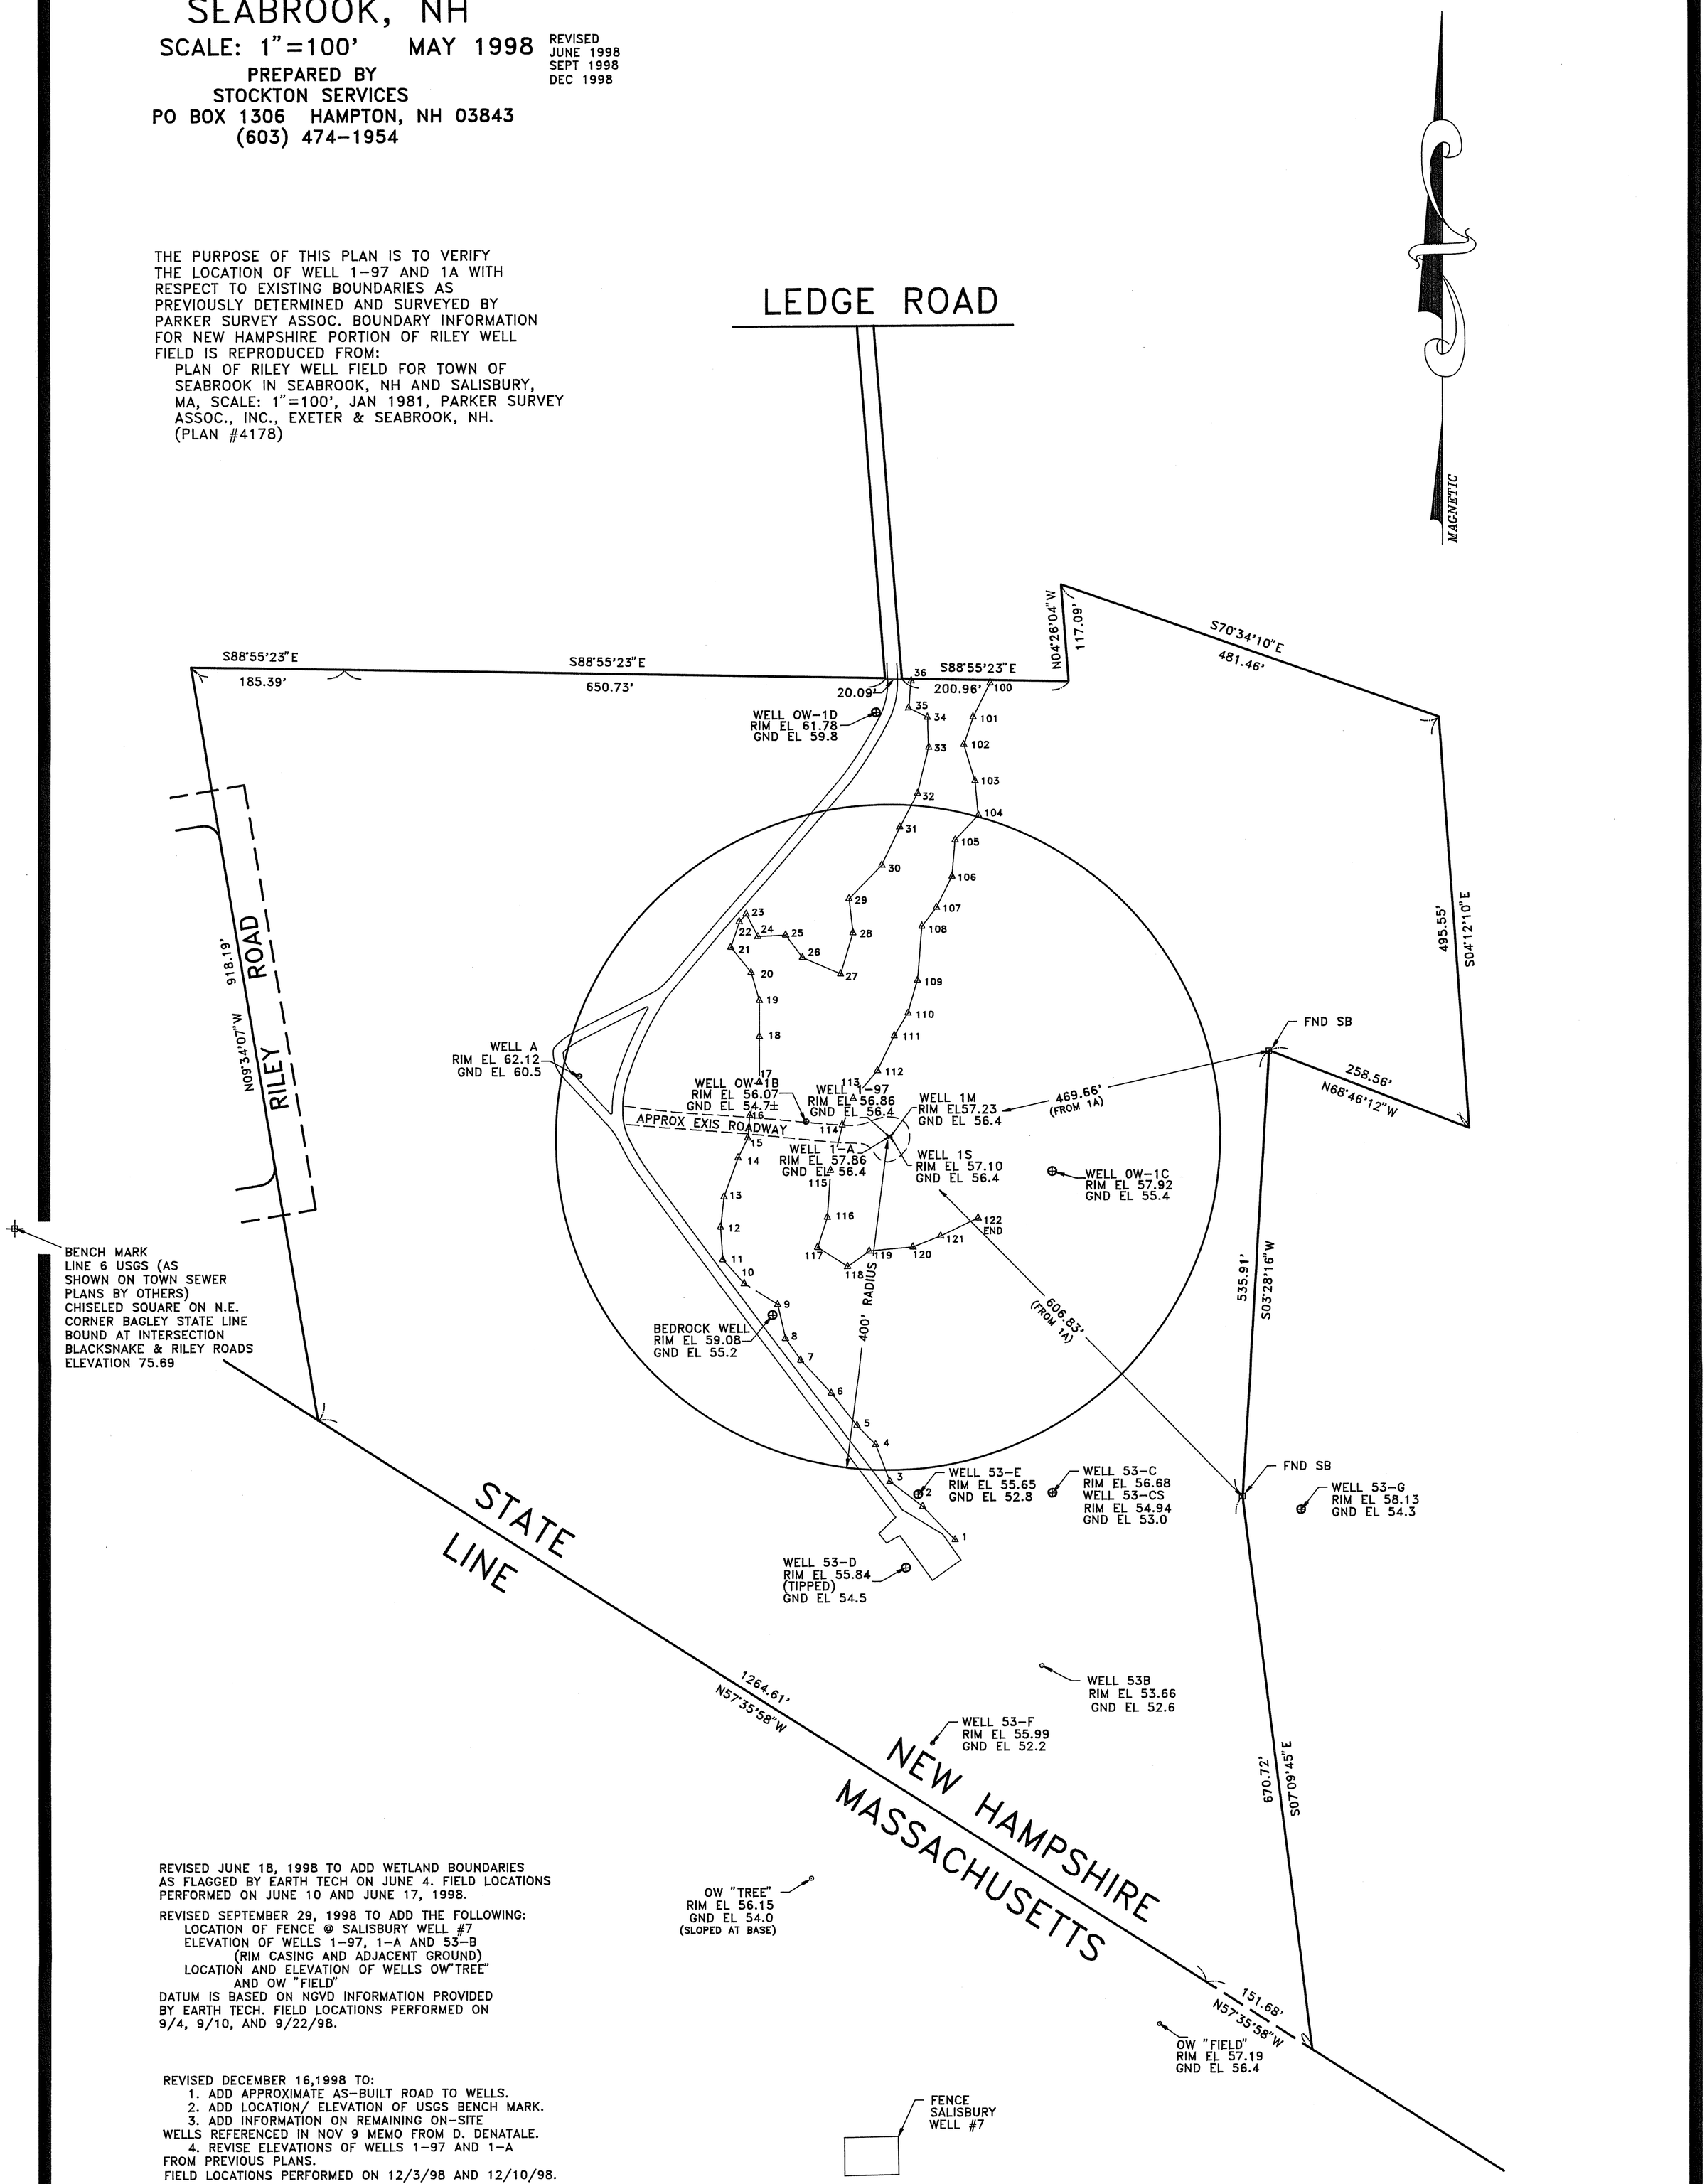

REVISED JUNE 18, 1998 TO ADD WETLAND BOUNDARIES AS FLAGGED BY EARTH TECH ON JUNE 4. FIELD LOCATIONS PERFORMED ON JUNE 10 AND JUNE 17, 1998.

REVISED SEPTEMBER 29, 1998 TO ADD THE FOLLOWING:
- LOCATION OF FENCE @ SALISBURY WELL #7
- ELEVATION OF WELLS 1-97, 1-A AND 53-B (RIM CASING AND ADJACENT GROUND)
- LOCATION AND ELEVATION OF WELLS OW"TREE" AND OW "FIELD"

DATUM IS BASED ON NGVD INFORMATION PROVIDED BY EARTH TECH. FIELD LOCATIONS PERFORMED ON 9/4, 9/10, AND 9/22/98.

REVISED DECEMBER 16,1998 TO:
1. ADD APPROXIMATE AS-BUILT ROAD TO WELLS.
2. ADD LOCATION/ ELEVATION OF USGS BENCH MARK.
3. ADD INFORMATION ON REMAINING ON-SITE WELLS REFERENCED IN NOV 9 MEMO FROM D. DENATALE.
4. REVISE ELEVATIONS OF WELLS 1-97 AND 1-A FROM PREVIOUS PLANS.

FIELD LOCATIONS PERFORMED ON 12/3/98 AND 12/10/98.

256 R3

ATTACHMENT D–PROJECT PLAN

WELL LOCATION PLAN
FOR
EARTH TECH, INC.
IN
SEABROOK, NH

SCALE: 1"=100' MAY 1998 REVISED JUNE 1998

PREPARED BY
STOCKTON SERVICES
PO BOX 1306 HAMPTON, NH 03843
(603) 474–1954

THE PURPOSE OF THIS PLAN IS TO VERIFY THE LOCATION OF WELL 1–97 AND 1A WITH RESPECT TO EXISTING BOUNDARIES AS PREVIOUSLY DETERMINED AND SURVEYED BY PARKER SURVEY ASSOC. BOUNDARY INFORMATION FOR NEW HAMPSHIRE PORTION OF RILEY WELL FIELD IS REPRODUCED FROM:
PLAN OF RILEY WELL FIELD FOR TOWN OF SEABROOK IN SEABROOK, NH AND SALISBURY, MA, SCALE: 1"=100', JAN 1981, PARKER SURVEY ASSOC., INC., EXETER & SEABROOK, NH. (PLAN #4178)

MAGNETIC

LEGEND

△ 103 –WETLAND FLAG LOCATION

(1) –PHOTOGRAPH LOCATION AND DIRECTION

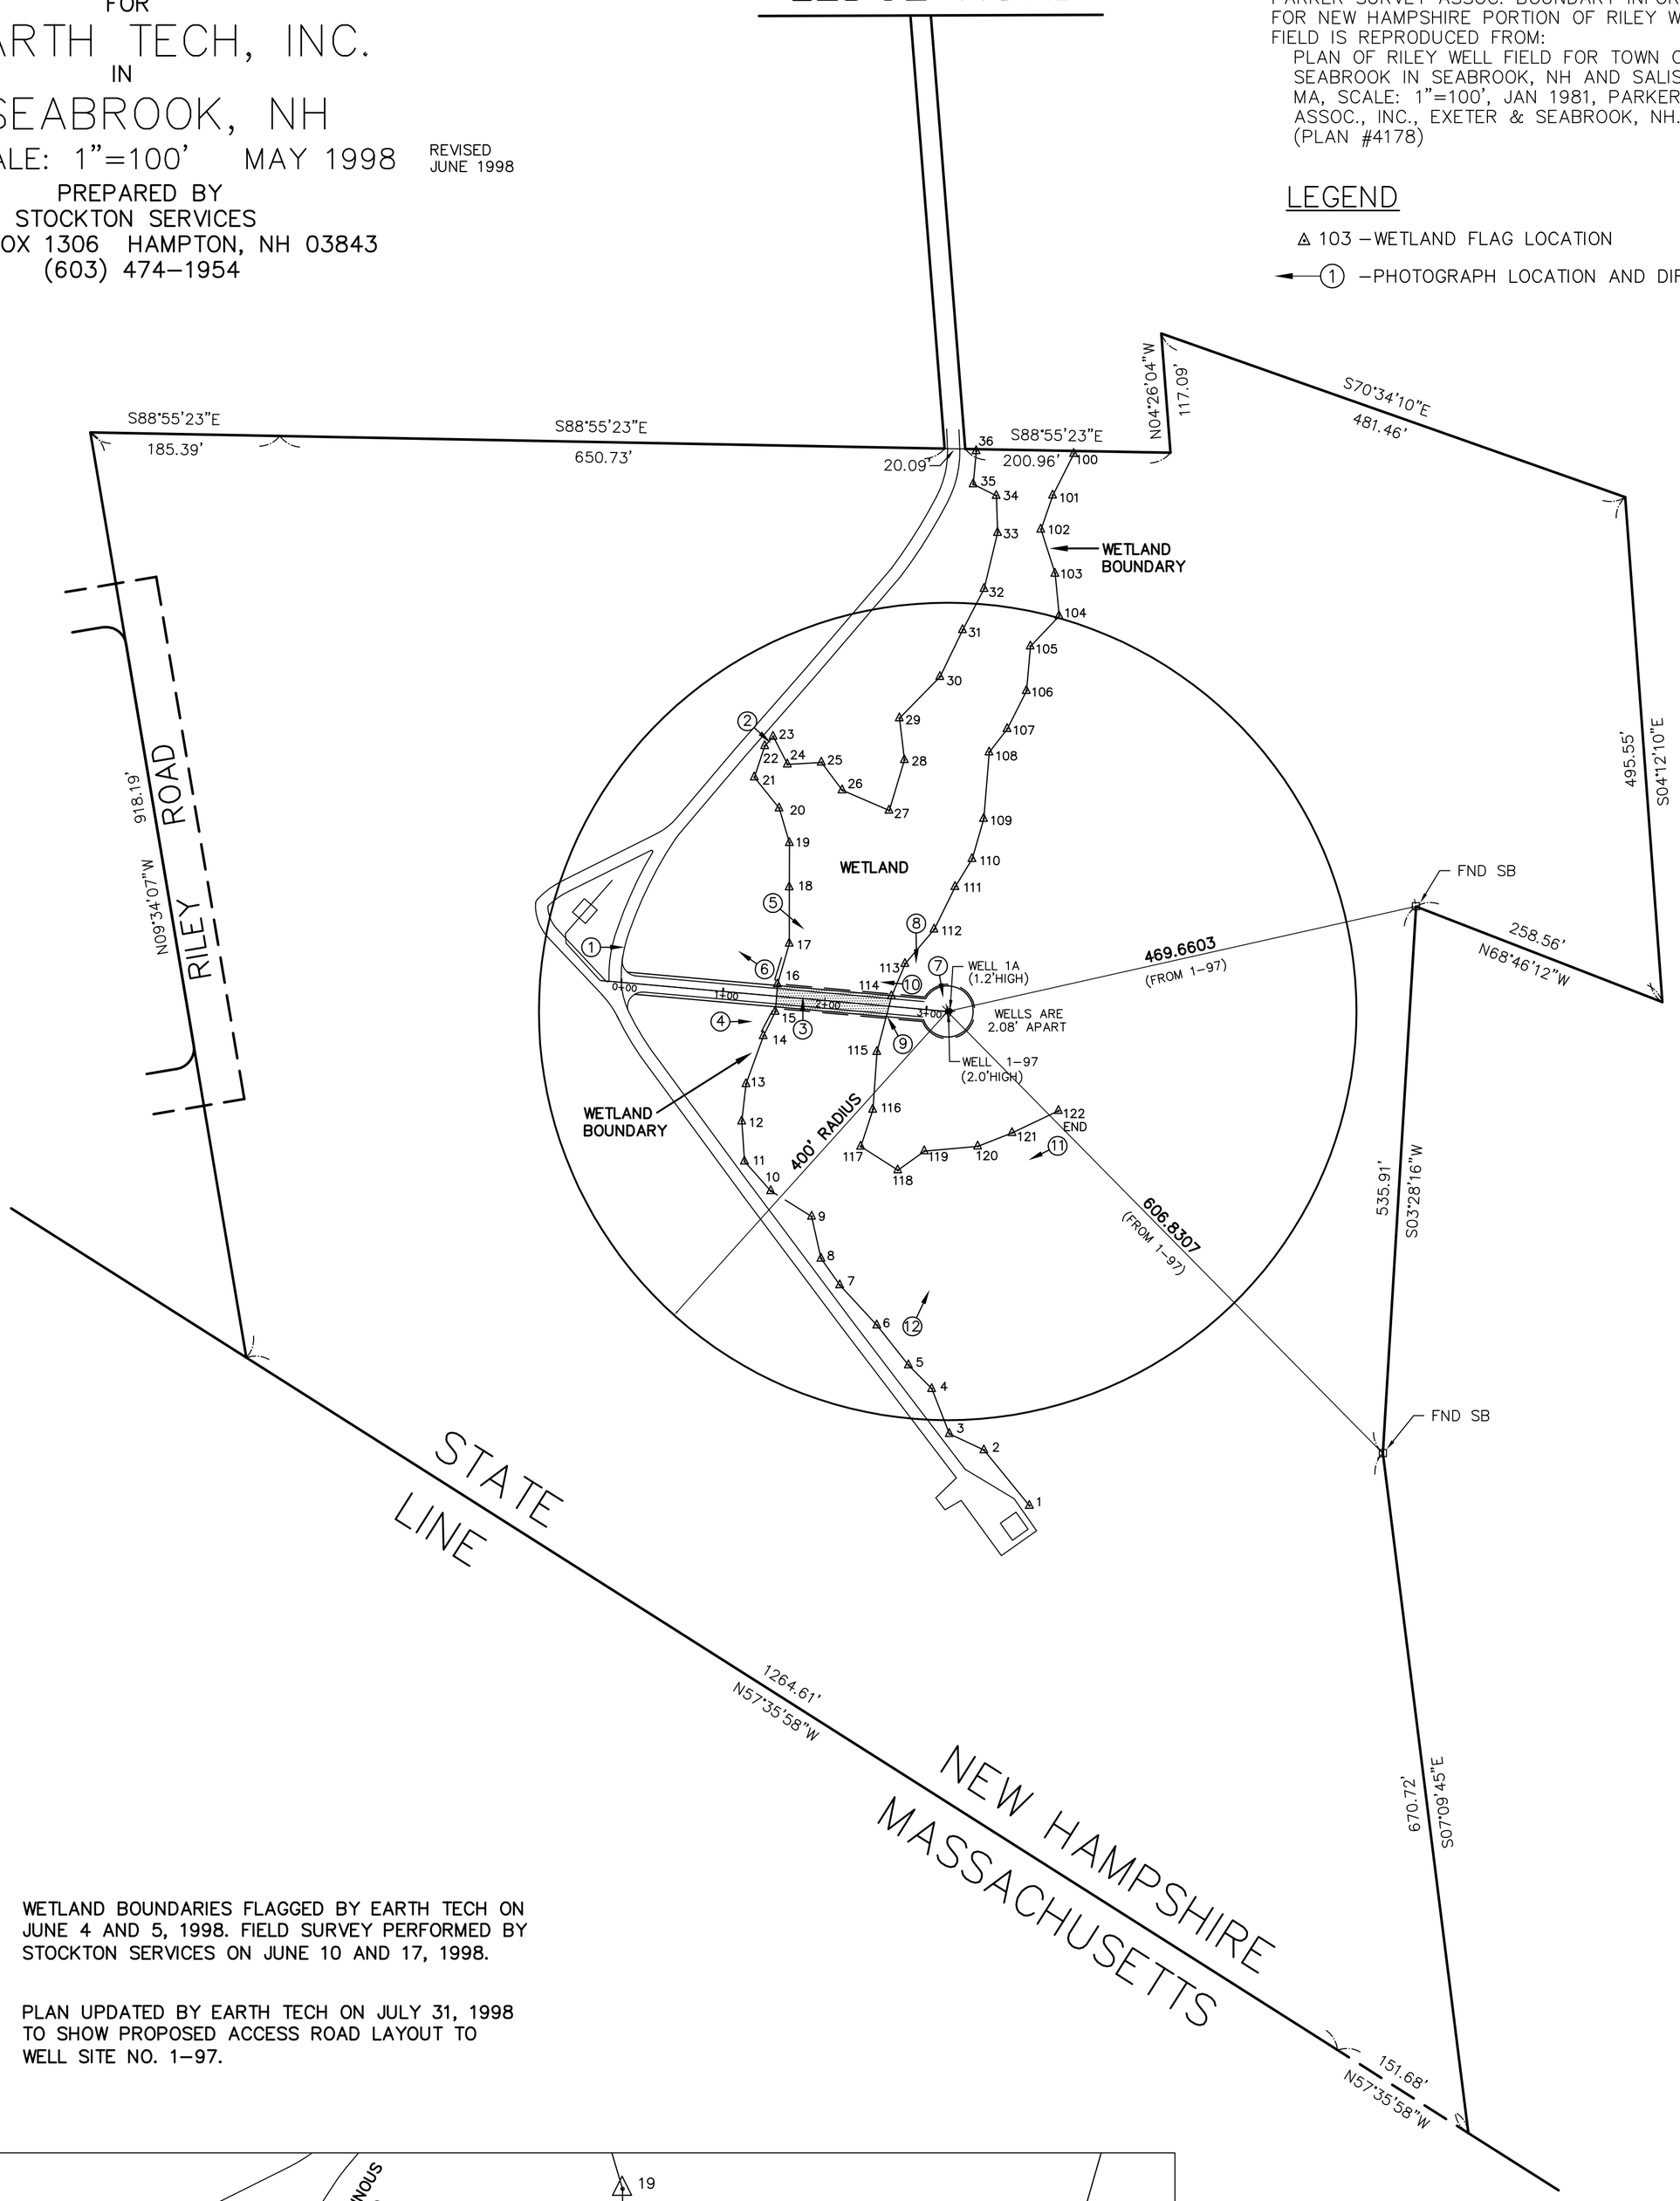

WETLAND BOUNDARIES FLAGGED BY EARTH TECH ON JUNE 4 AND 5, 1998. FIELD SURVEY PERFORMED BY STOCKTON SERVICES ON JUNE 10 AND 17, 1998.

PLAN UPDATED BY EARTH TECH ON JULY 31, 1998 TO SHOW PROPOSED ACCESS ROAD LAYOUT TO WELL SITE NO. 1–97.

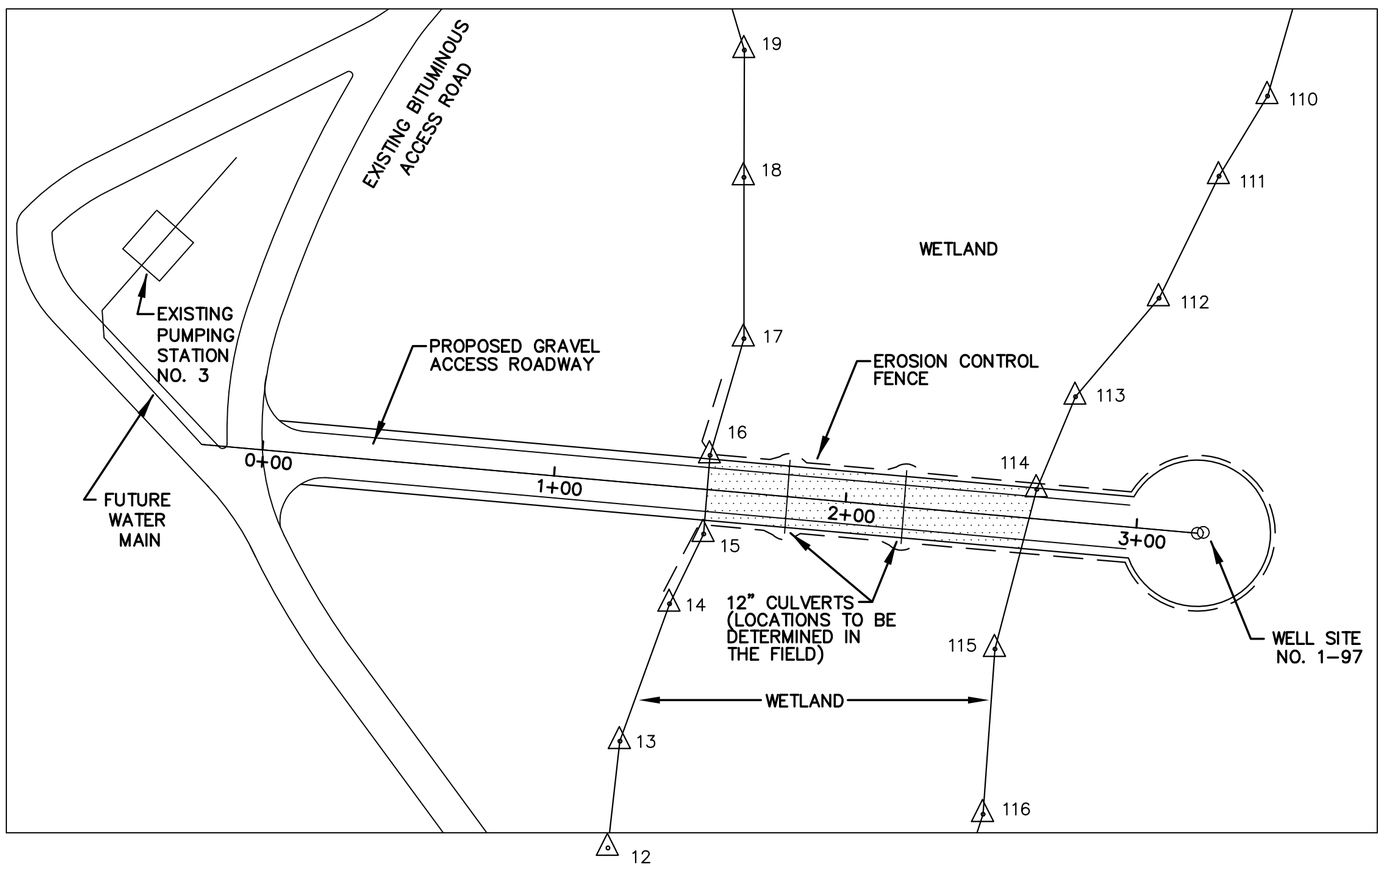

ENLARGEMENT OF PROPOSED ACCESS ROAD TO WELL SITE NO. 1–97
SCALE: 1"=40'

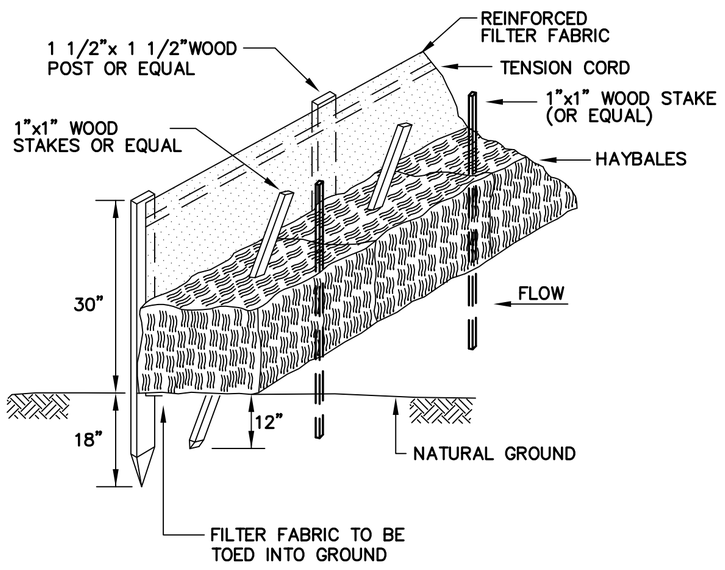

EROSION CONTROL FENCE DETAIL
NTS